

Elizabeth Grafton

Atkins Highways & Transportation  
260 Aztec West Park Aveune Almondsbury

Virgin Media  
National Plant Enquiries  
Cablephone House  
Small Heath Business Park  
Talbot Way  
Birmingham  
B10 0HJ

Tel: 0870 888 3116 Opt 2

Fax: 0121 694 2345

Drawing Ref: 11075 31/01/2008  
Plant Enquiry VM/PLE/011075  
Your Letter Date 22/01/2008  
Your Ref: 7253/LG  
Date: 31/01/2008

Dear Sir / Madam,

Enquiry Location: **Garthland House, Garthland Lane, Paisley  
PA1 3PY**

Thank you for your enquiry regarding work at the above location.

I enclose a copy of our above referenced drawing, marked to show the approximate position of plant owned and operated by Virgin Media.

You will be aware that you have a duty to ensure that no damage results to this equipment as a result of your proposed works. Please note that this apparatus may contain Fibre Optic, Coaxial and/or 240v Power Cables and as such, special care must be taken when excavating this area.

**Should you require Virgin Media apparatus to be diverted to accommodate your works, please provide a detailed drawing of your works to:**

**Diversiory Works Team.  
Unit 7, Bothwell Park Ind Est.  
Uddingston  
G71 6NZ**

**Should your request be in relation to a new development and you require an estimate to be prepared for Virgin Media to service your proposed development, please submit this request for costs along with site drawings (scale 1:500) to the New Developments Team also at the above address.**

Yours faithfully,


National Plant Enquiries Team

email: [plant.enquiries.team@virginmedia.co.uk](mailto:plant.enquiries.team@virginmedia.co.uk)

Please note: National Plant Enquiries Team (Birmingham) cover and respond to plant enquiries for all ex ntl:Telewest franchise areas

DD

# ntl:Telewest Plant Enquiry Response

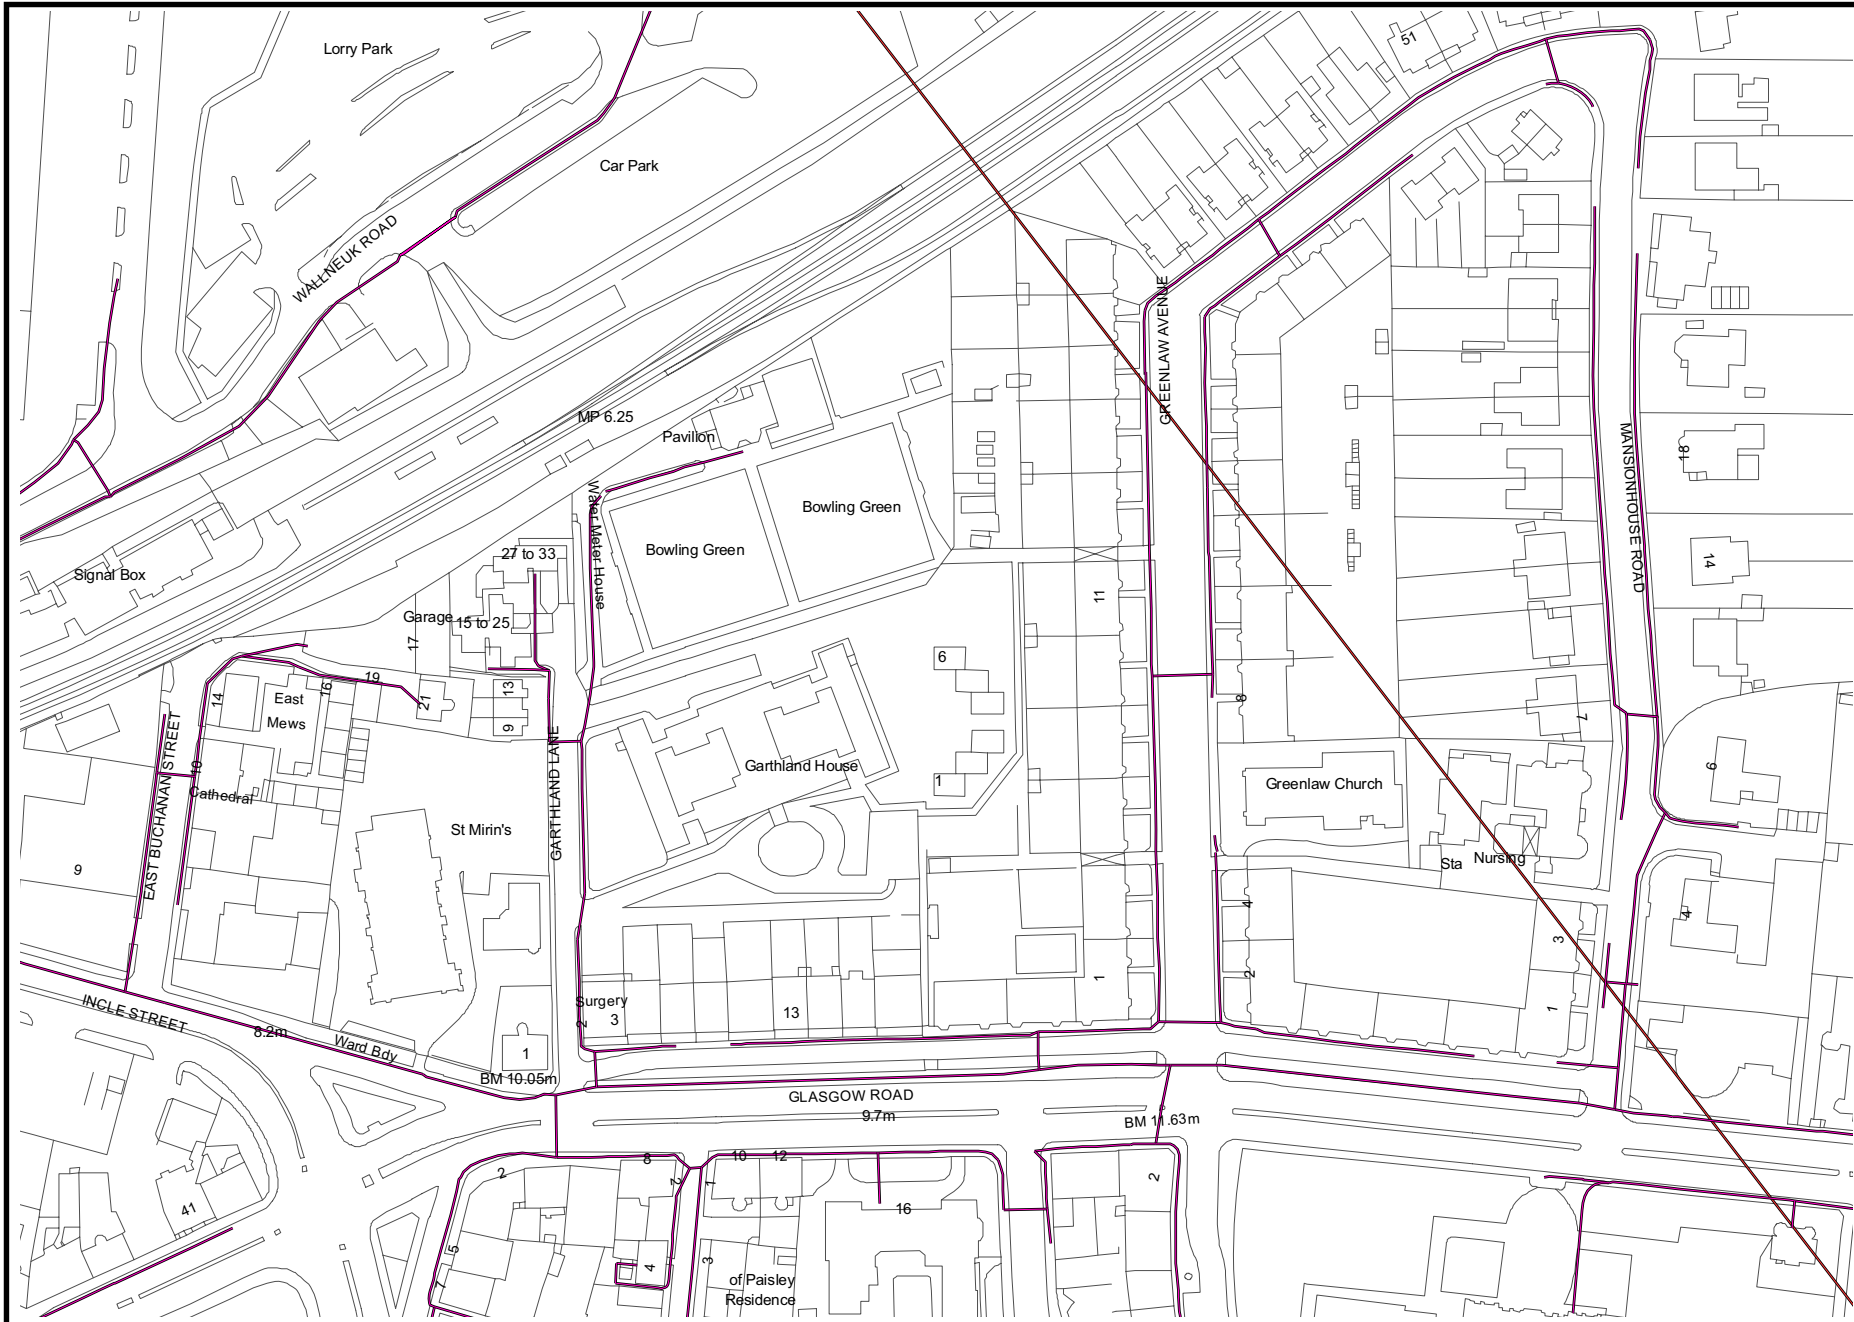

**LEGEND**

- Trench
- Core Trench

**Depth of Cover**

Footway - 250mm  
 Carriageway  
 Type 1 - 600mm  
 Type 2 - 600mm  
 Type 3 - 450mm  
 Type 4 - 450mm

Duct type -  
 96mm & 54mm UPVC green

**Disclaimer:**  
 The information shown on this plan is given without obligation or warranty. It is intended for general guidance only. No liability whatsoever is accepted by ntl, its agents or servants for any error or omission. The actual position of plant must be verified and established on site prior to any excavation.

© Crown Copyright  
 OS License CC38012C0001  
**Scale 1:1,500**